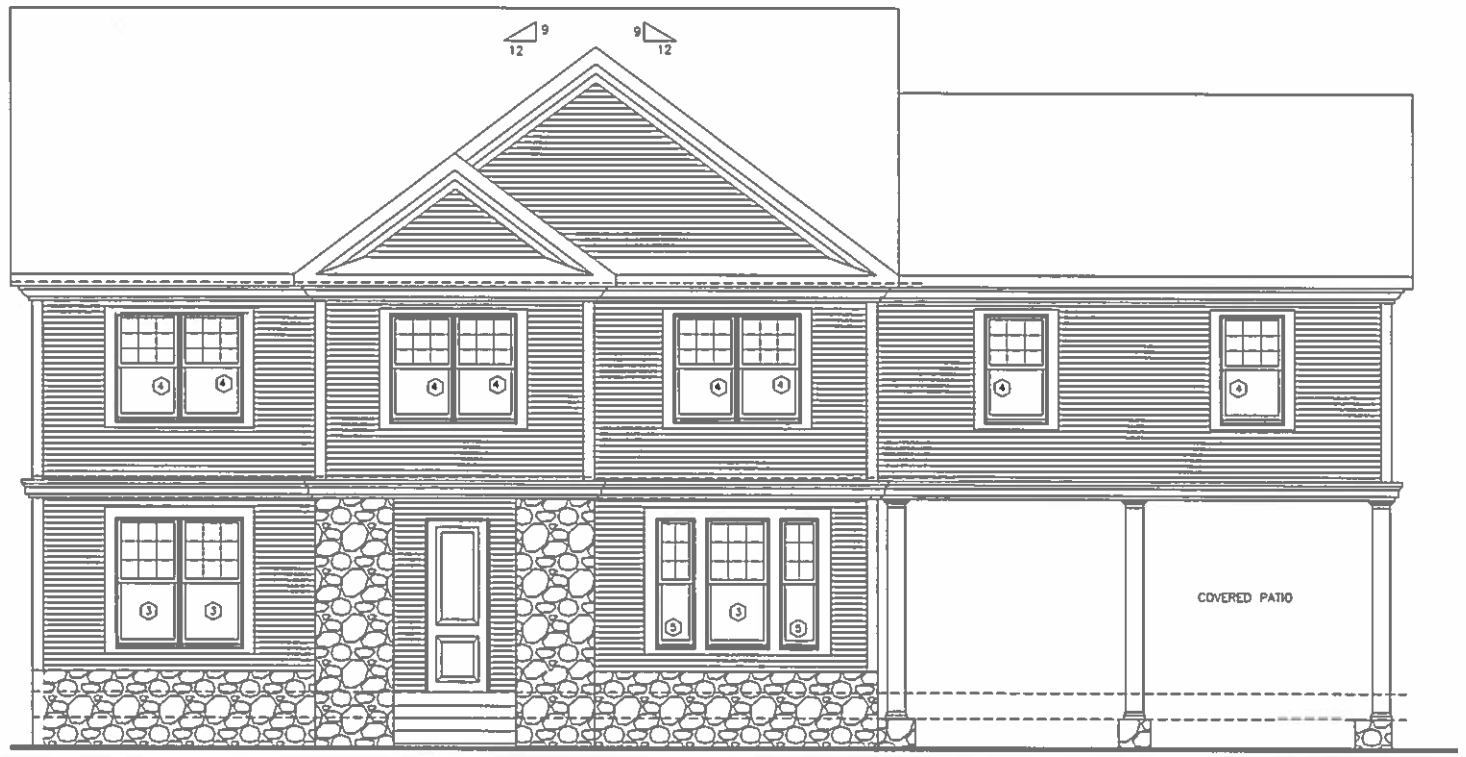

FRONT ELEVATION

RIGHT SIDE ELEVATION

REAR ELEVATION

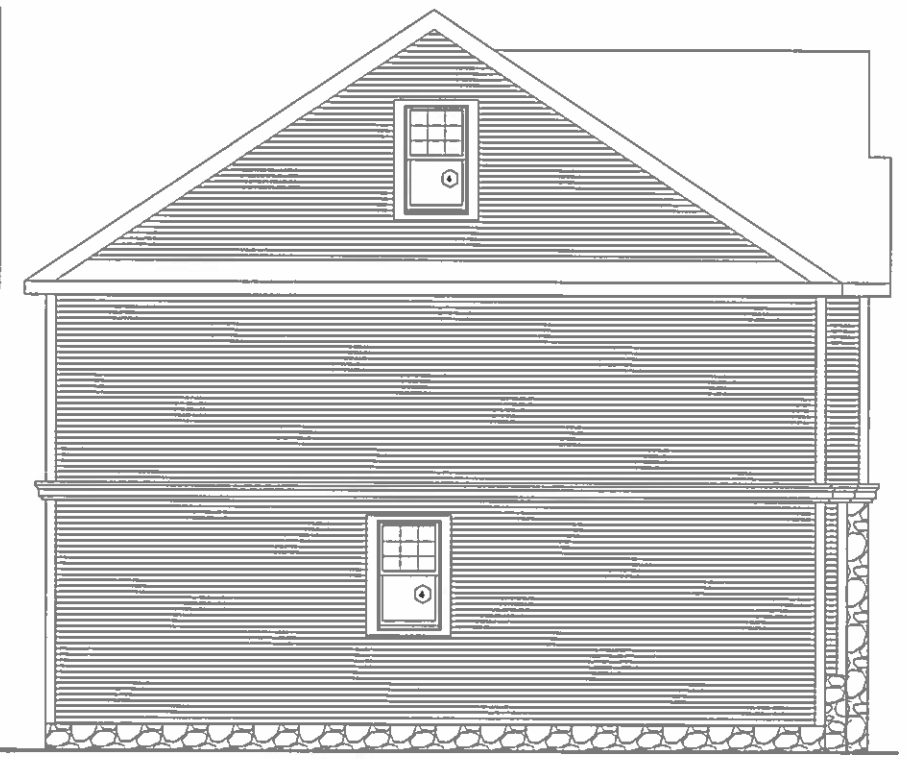

LEFT SIDE ELEVATION

DATE	REVISION
8/28/18	REVISED FOR AS-BUILT FOUNDATION

All legal rights including, but not limited to, copyright and design patent rights, in the designs, arrangements and plans shown on the document are the property of RAV&Assoc., Inc. They may not be used or reused in whole or in part, except in connection with this project, without the pre-written consent of RAV&Assoc., Inc. Written dimensions on these drawings shall have precedence over scaled dimensions. Contractors shall verify and be responsible for all dimensions and conditions on this project, and RAV&Assoc. Inc must be notified of any variation from the dimensions and conditions shown by these drawings.

ELEVATIONS

23 WASHINGTON ST.,
ASHLAND, MASSACHUSETTS

RAV & Assoc., Inc.
21 HIGHLAND AVENUE
NEEDHAM, MASSACHUSETTS 02494
TELEPHONE: (781) 449-8200 FAX: (781) 449-8205

SCALE: 1/4"=1'-0"

APPROVED: RAV	DESIGNED BY: I.M.	DRAWING No.
DATE: 07/22/2018	DRAWN BY: I.M.	A-2
	CHECKED BY: R.A.V	